

DEPARTMENT OF TRANSPORTATION  
STATE OF GEORGIA



INTERDEPARTMENT CORRESPONDENCE

FILE: NH000-0073-03-(242) & NH000-0575-01(028)  
P3 Projects Cobb/Cherokee  
P.I. No. 614130- & 713640-

OFFICE: Cartersville

DATE: July 13, 2010

FROM: Kent L. Sager, District Engineer

TO: ~~Bobby Hilliard, State Program Delivery Engineer~~

ATTN: ~~John Hancock~~ John Hancock

*Danny L Van Meter, State INNOVATIVE Program Delivery*  
*INNOVATIVE PROGRAM Delivery*

SUBJECT: Cobb County-Marietta Water Authority

Attached, for your information, are plans from Cobb County-Marietta Water Authority showing their existing facilities on the above file project. Please have any necessary changes included in the plans.


If you have any questions, please contact Jennifer Deems at (770) 387-3616.


*KDB*  
BY: Kerry D. Bonner  
District Utilities Engineer

KLS/KDB/jd

Attachment

C: File

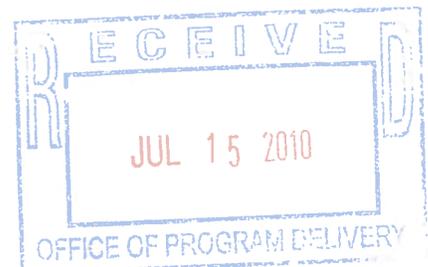

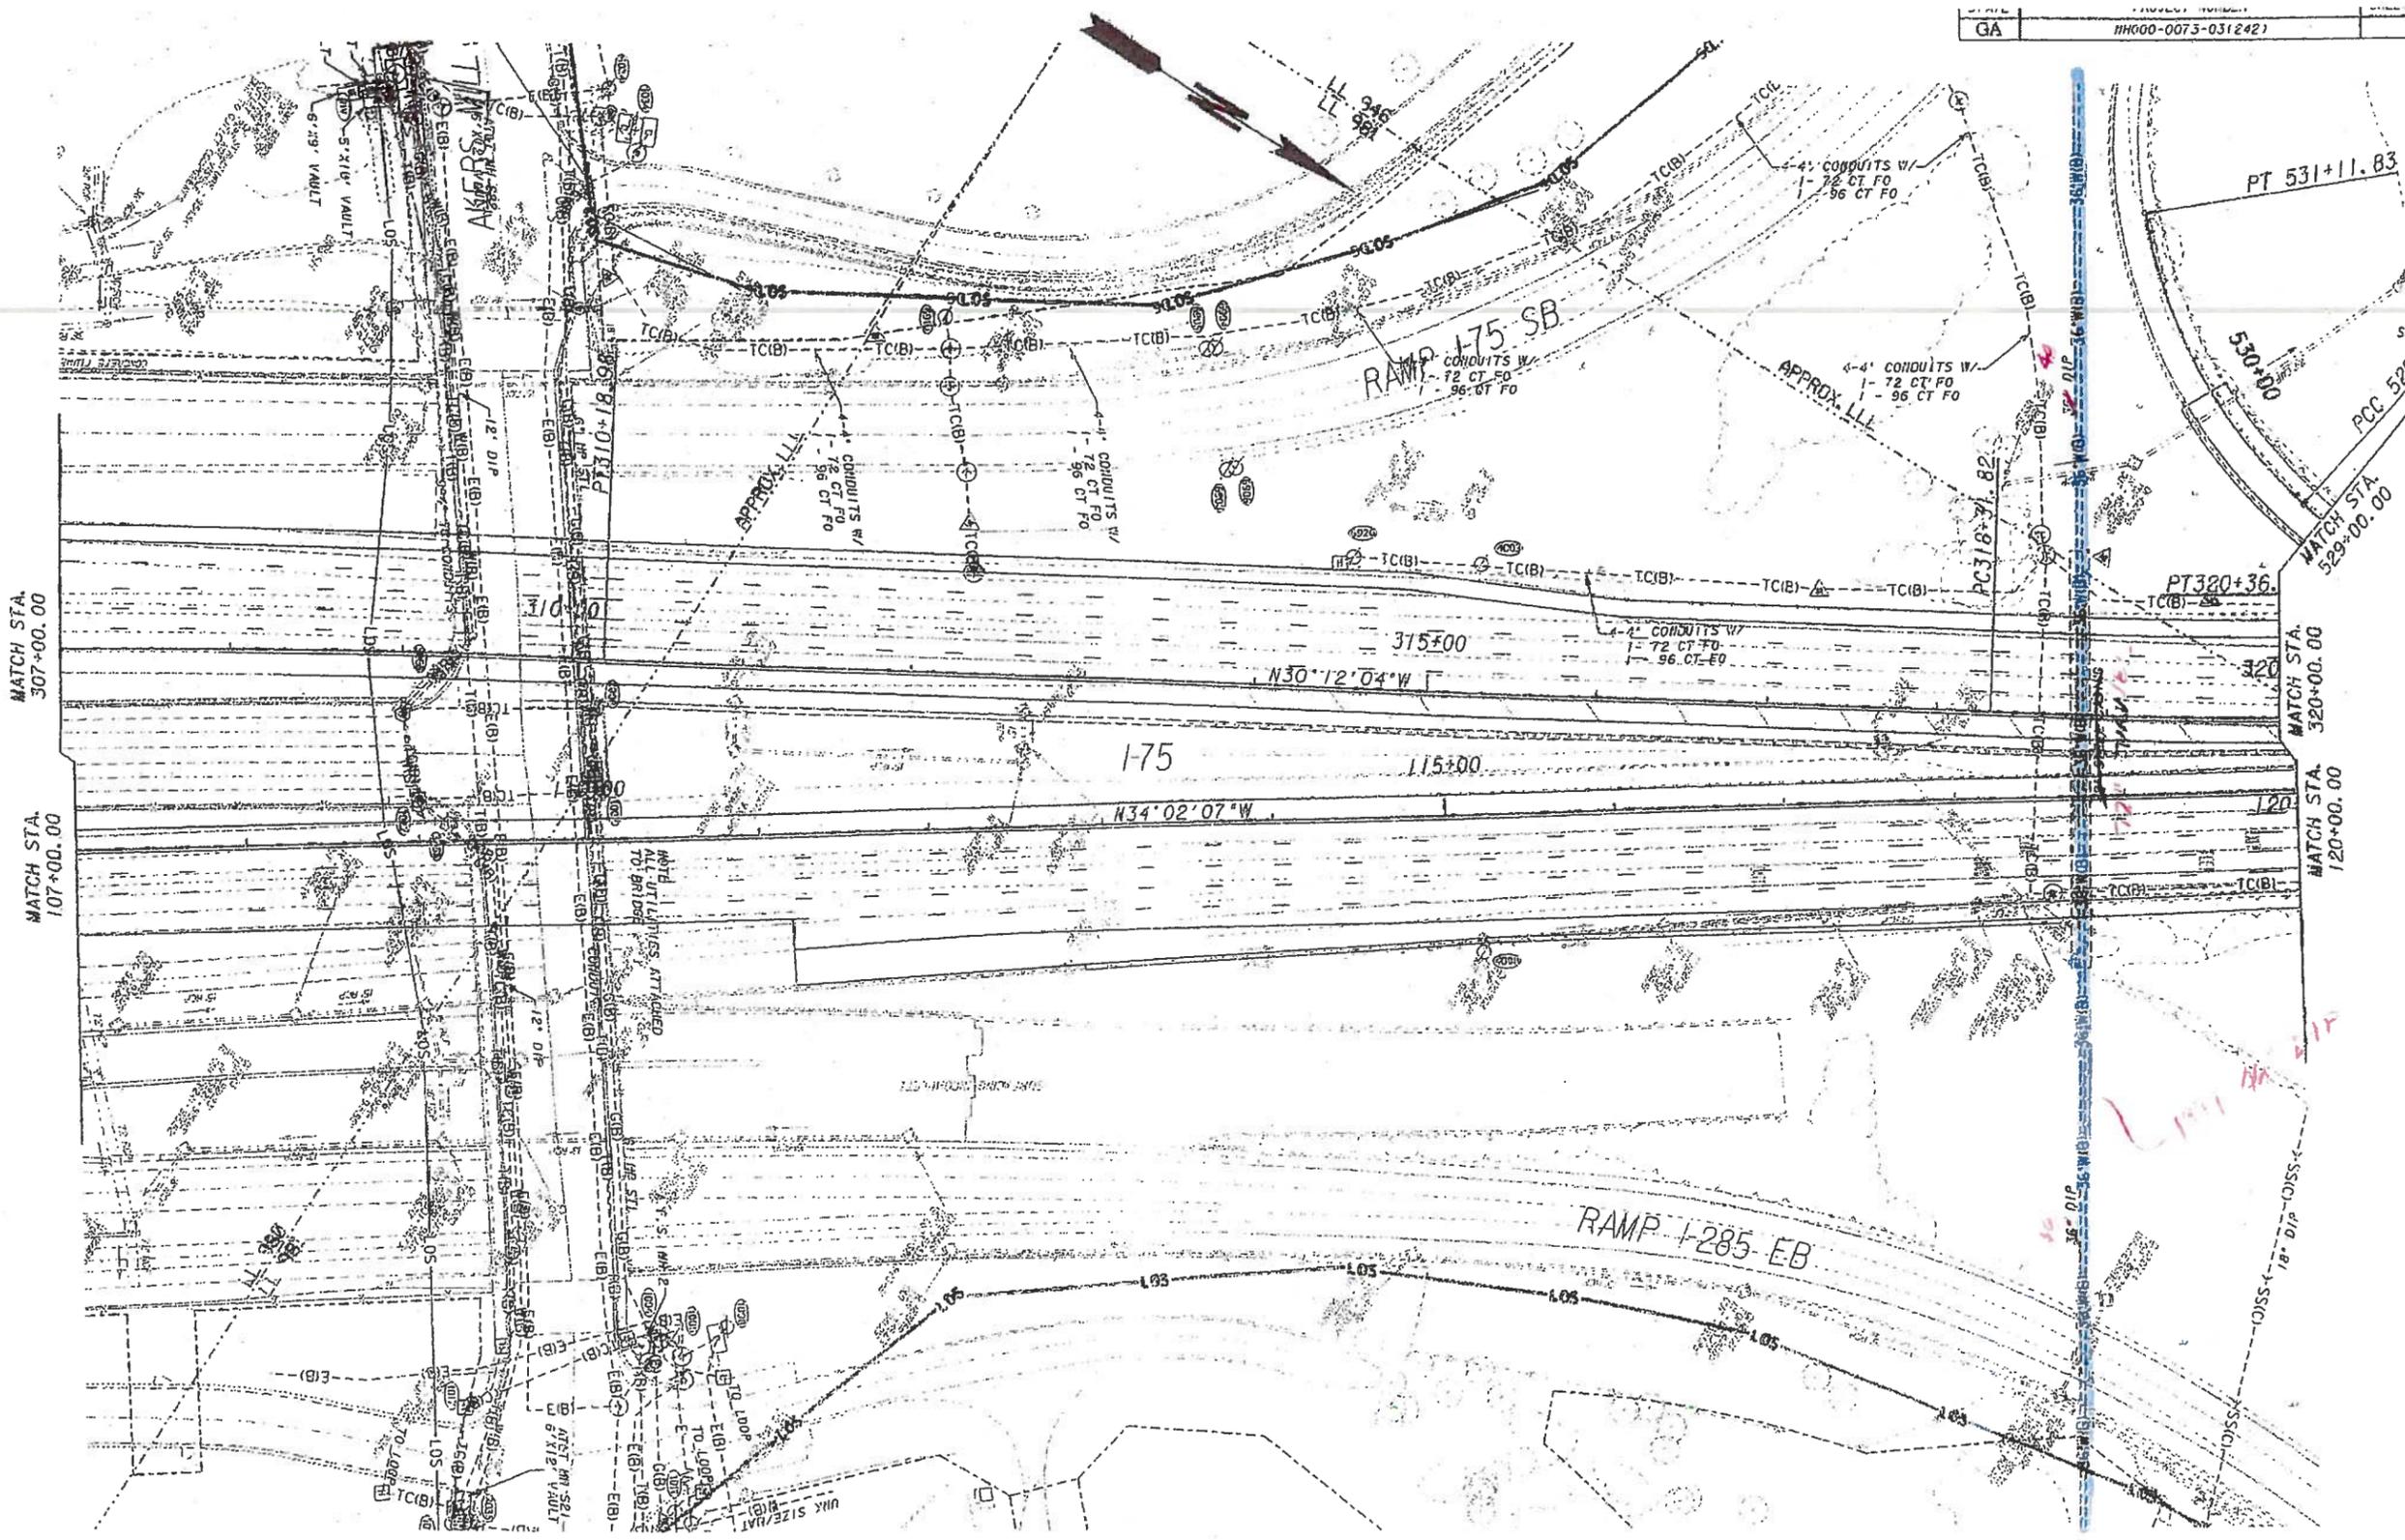

17-AUG-2009 08:14  
 8/17/2009  
 D:\175\den\141300\13-2.dwg  
 CLARA CASH  
 6/17/09  
 PATRICK TSE  
 6/17/09  
 MIKE MOSELEY  
 6/17/09  
 RUST HODGINS  
 6/17/09

TRACKING		NO	DATE	DESCRIPTION	ORIG	CHKR	SUPV	APPR
			6/17/09	FIRST UTILITY SUBMISSION	CCC	PCT	ACM	BHM

**GTP** GEORGIA TRANSPORTATION PARTNERS

SCALE IN FEET  
0 50 100 200



DEPARTMENT OF TRANSPORTATION  
STATE OF GEORGIA

**PBS&J**

I-75 / I-575 NORTHWEST CORRIDOR


**CONSTRUCTION PLAN**

I-75 REVERSIBLE

DRAWING NO. 13-2

Land Lot 981, 946  
17th District



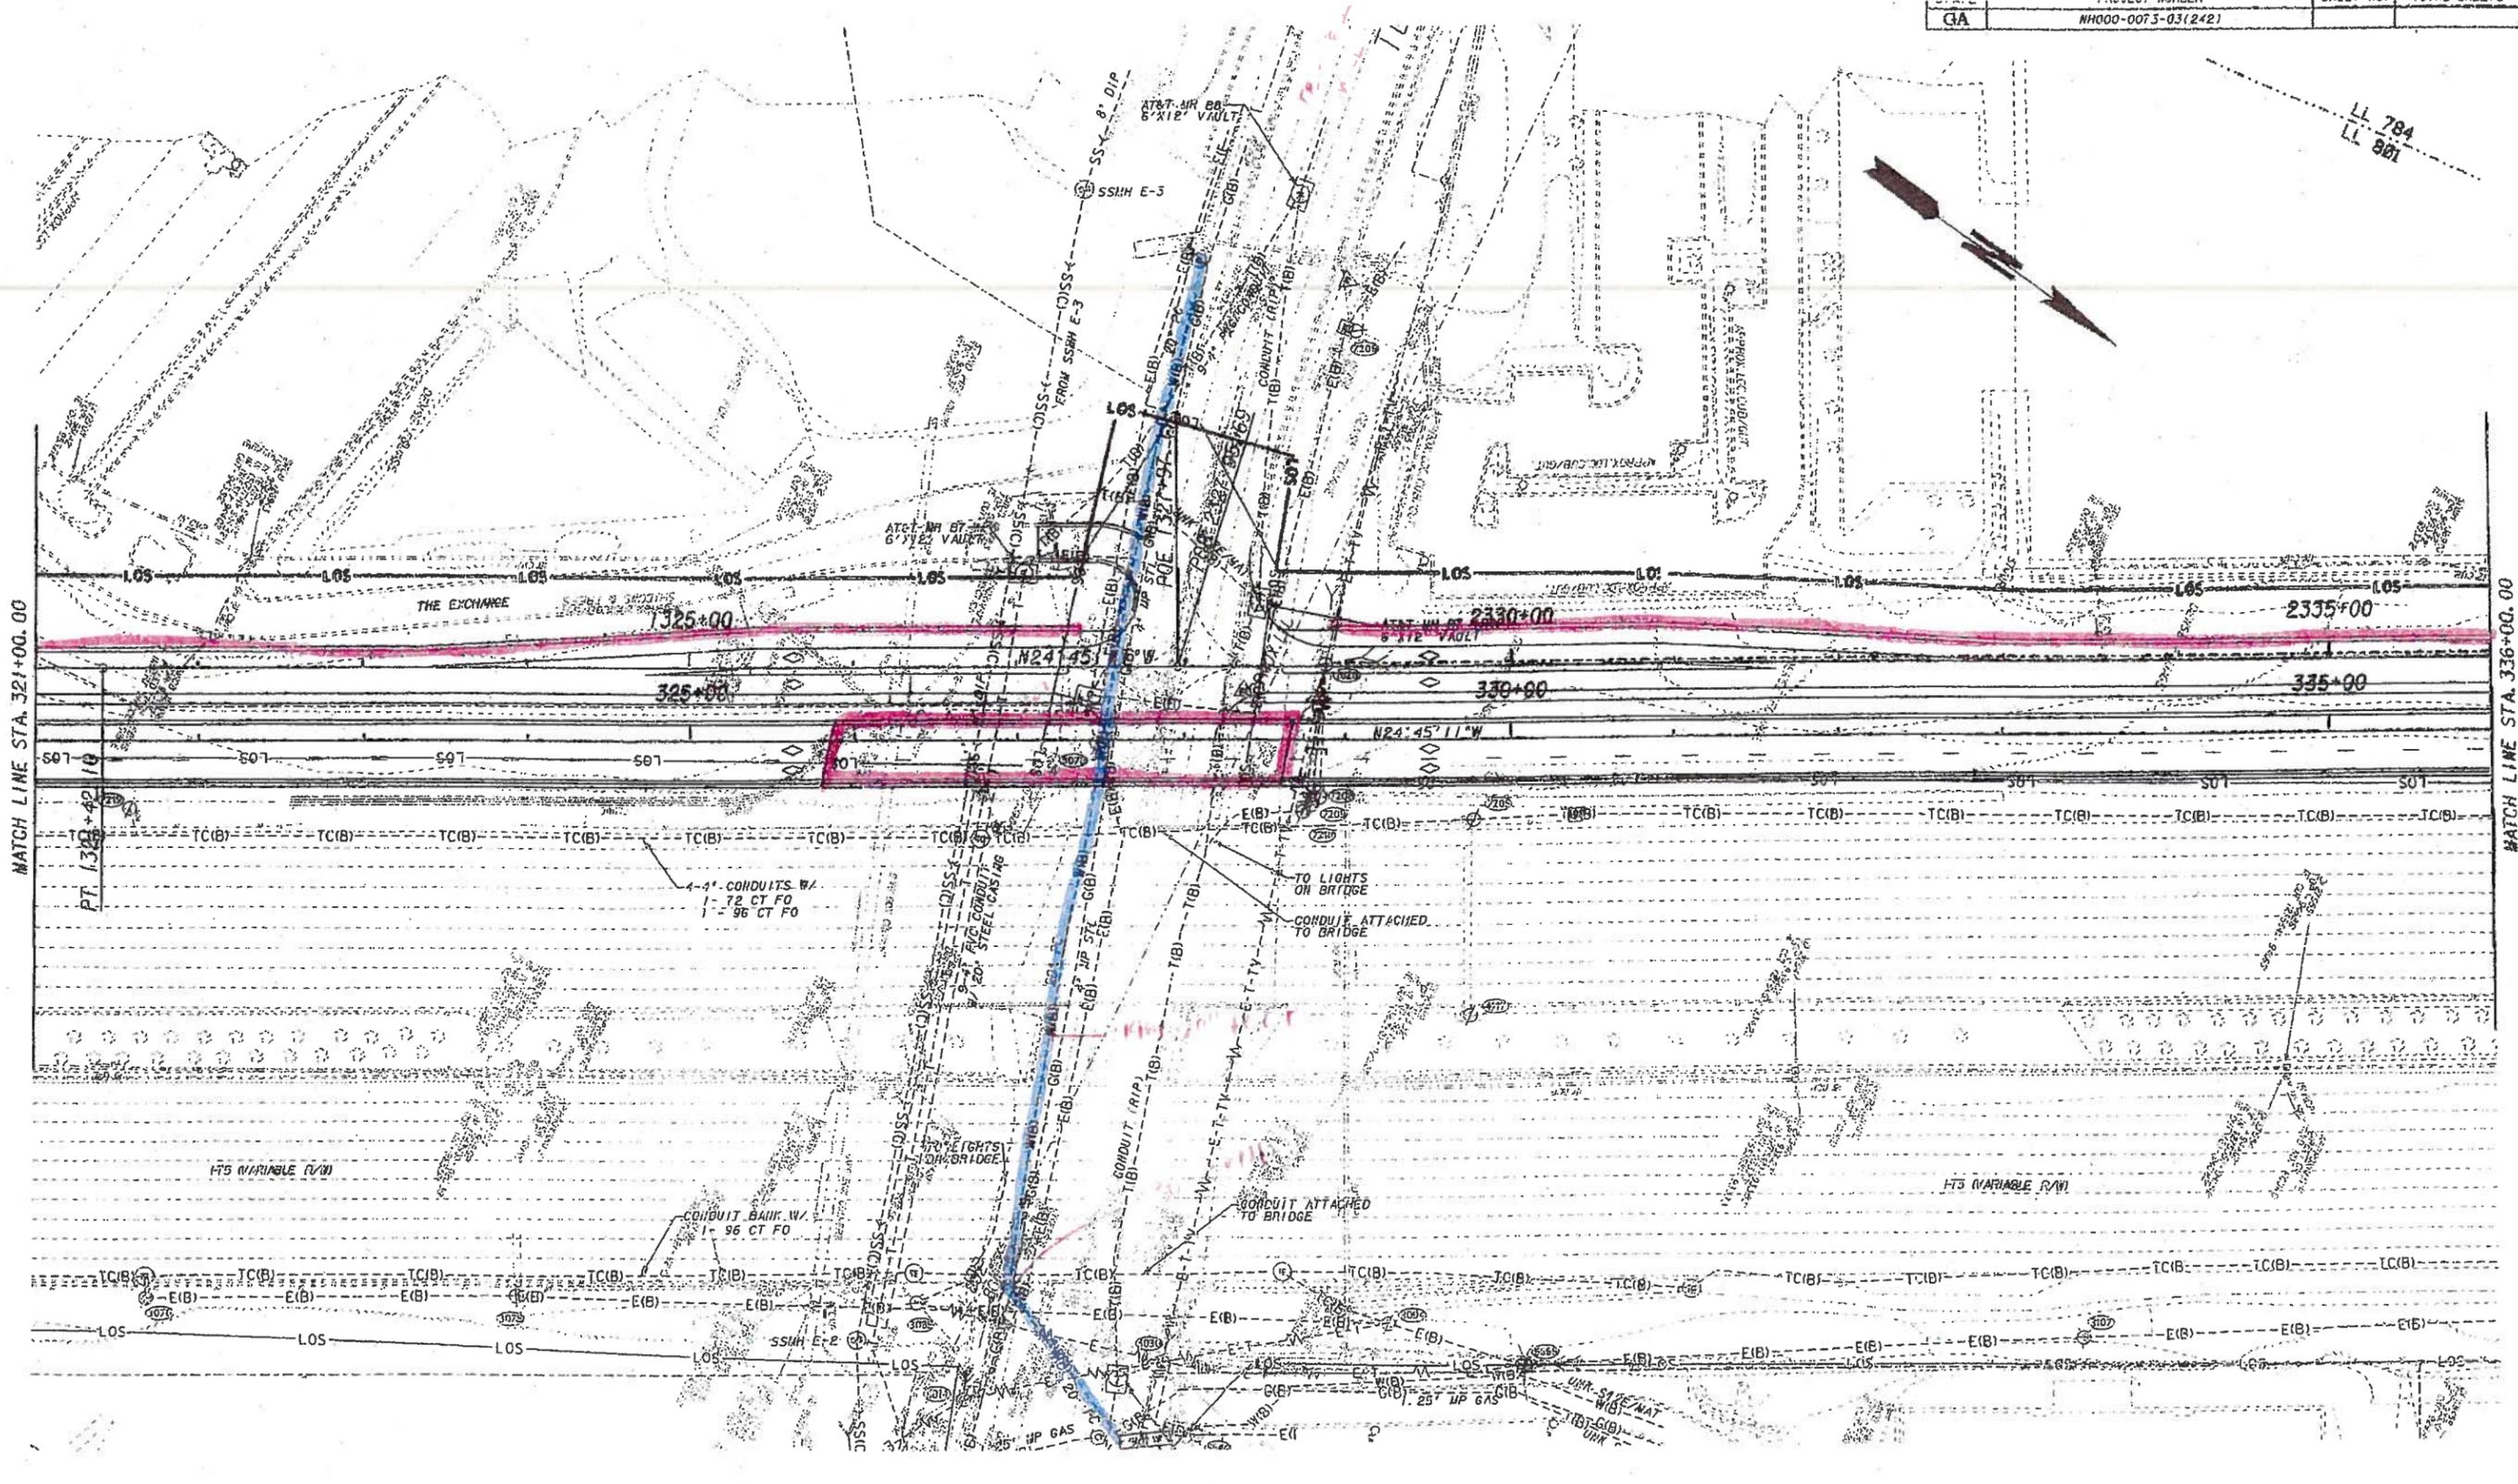

MATCH LINE STA. 321+00.00

MATCH LINE STA. 336+00.00

17-RUF-28895 NR17  
 9/17/2009  
 0A175-dgn\171308P10.dgn

TRACKING		NO	DATE	DESCRIPTION	ORIG	CHKR	SUPV	APPR
CLERA CASH	0/17/09							
DRAWN BY	DATE		2/17/09	FIRST UTILITY SUBMISSION	CEC	FCT	ARE	RAH
PATRICK TSE	DATE							
CHECKED BY	DATE							
WHE MOSELEY	DATE							
SUPERVISOR	DATE							
RONI LUDWIS	DATE							
APPROVED	DATE							

**GTP** GEORGIA TRANSPORTATION PARTNERS

SCALE IN FEET  
 0 50 100 200



DEPARTMENT OF TRANSPORTATION  
 STATE OF GEORGIA


**PBS&J**

I-75 / I-575 NORTHWEST CORRIDOR  
**CONSTRUCTION PLAN**  
 I-75 REVERSIBLE

DRAWING No. 13-10

LAND LOT 923  
 17th DIST



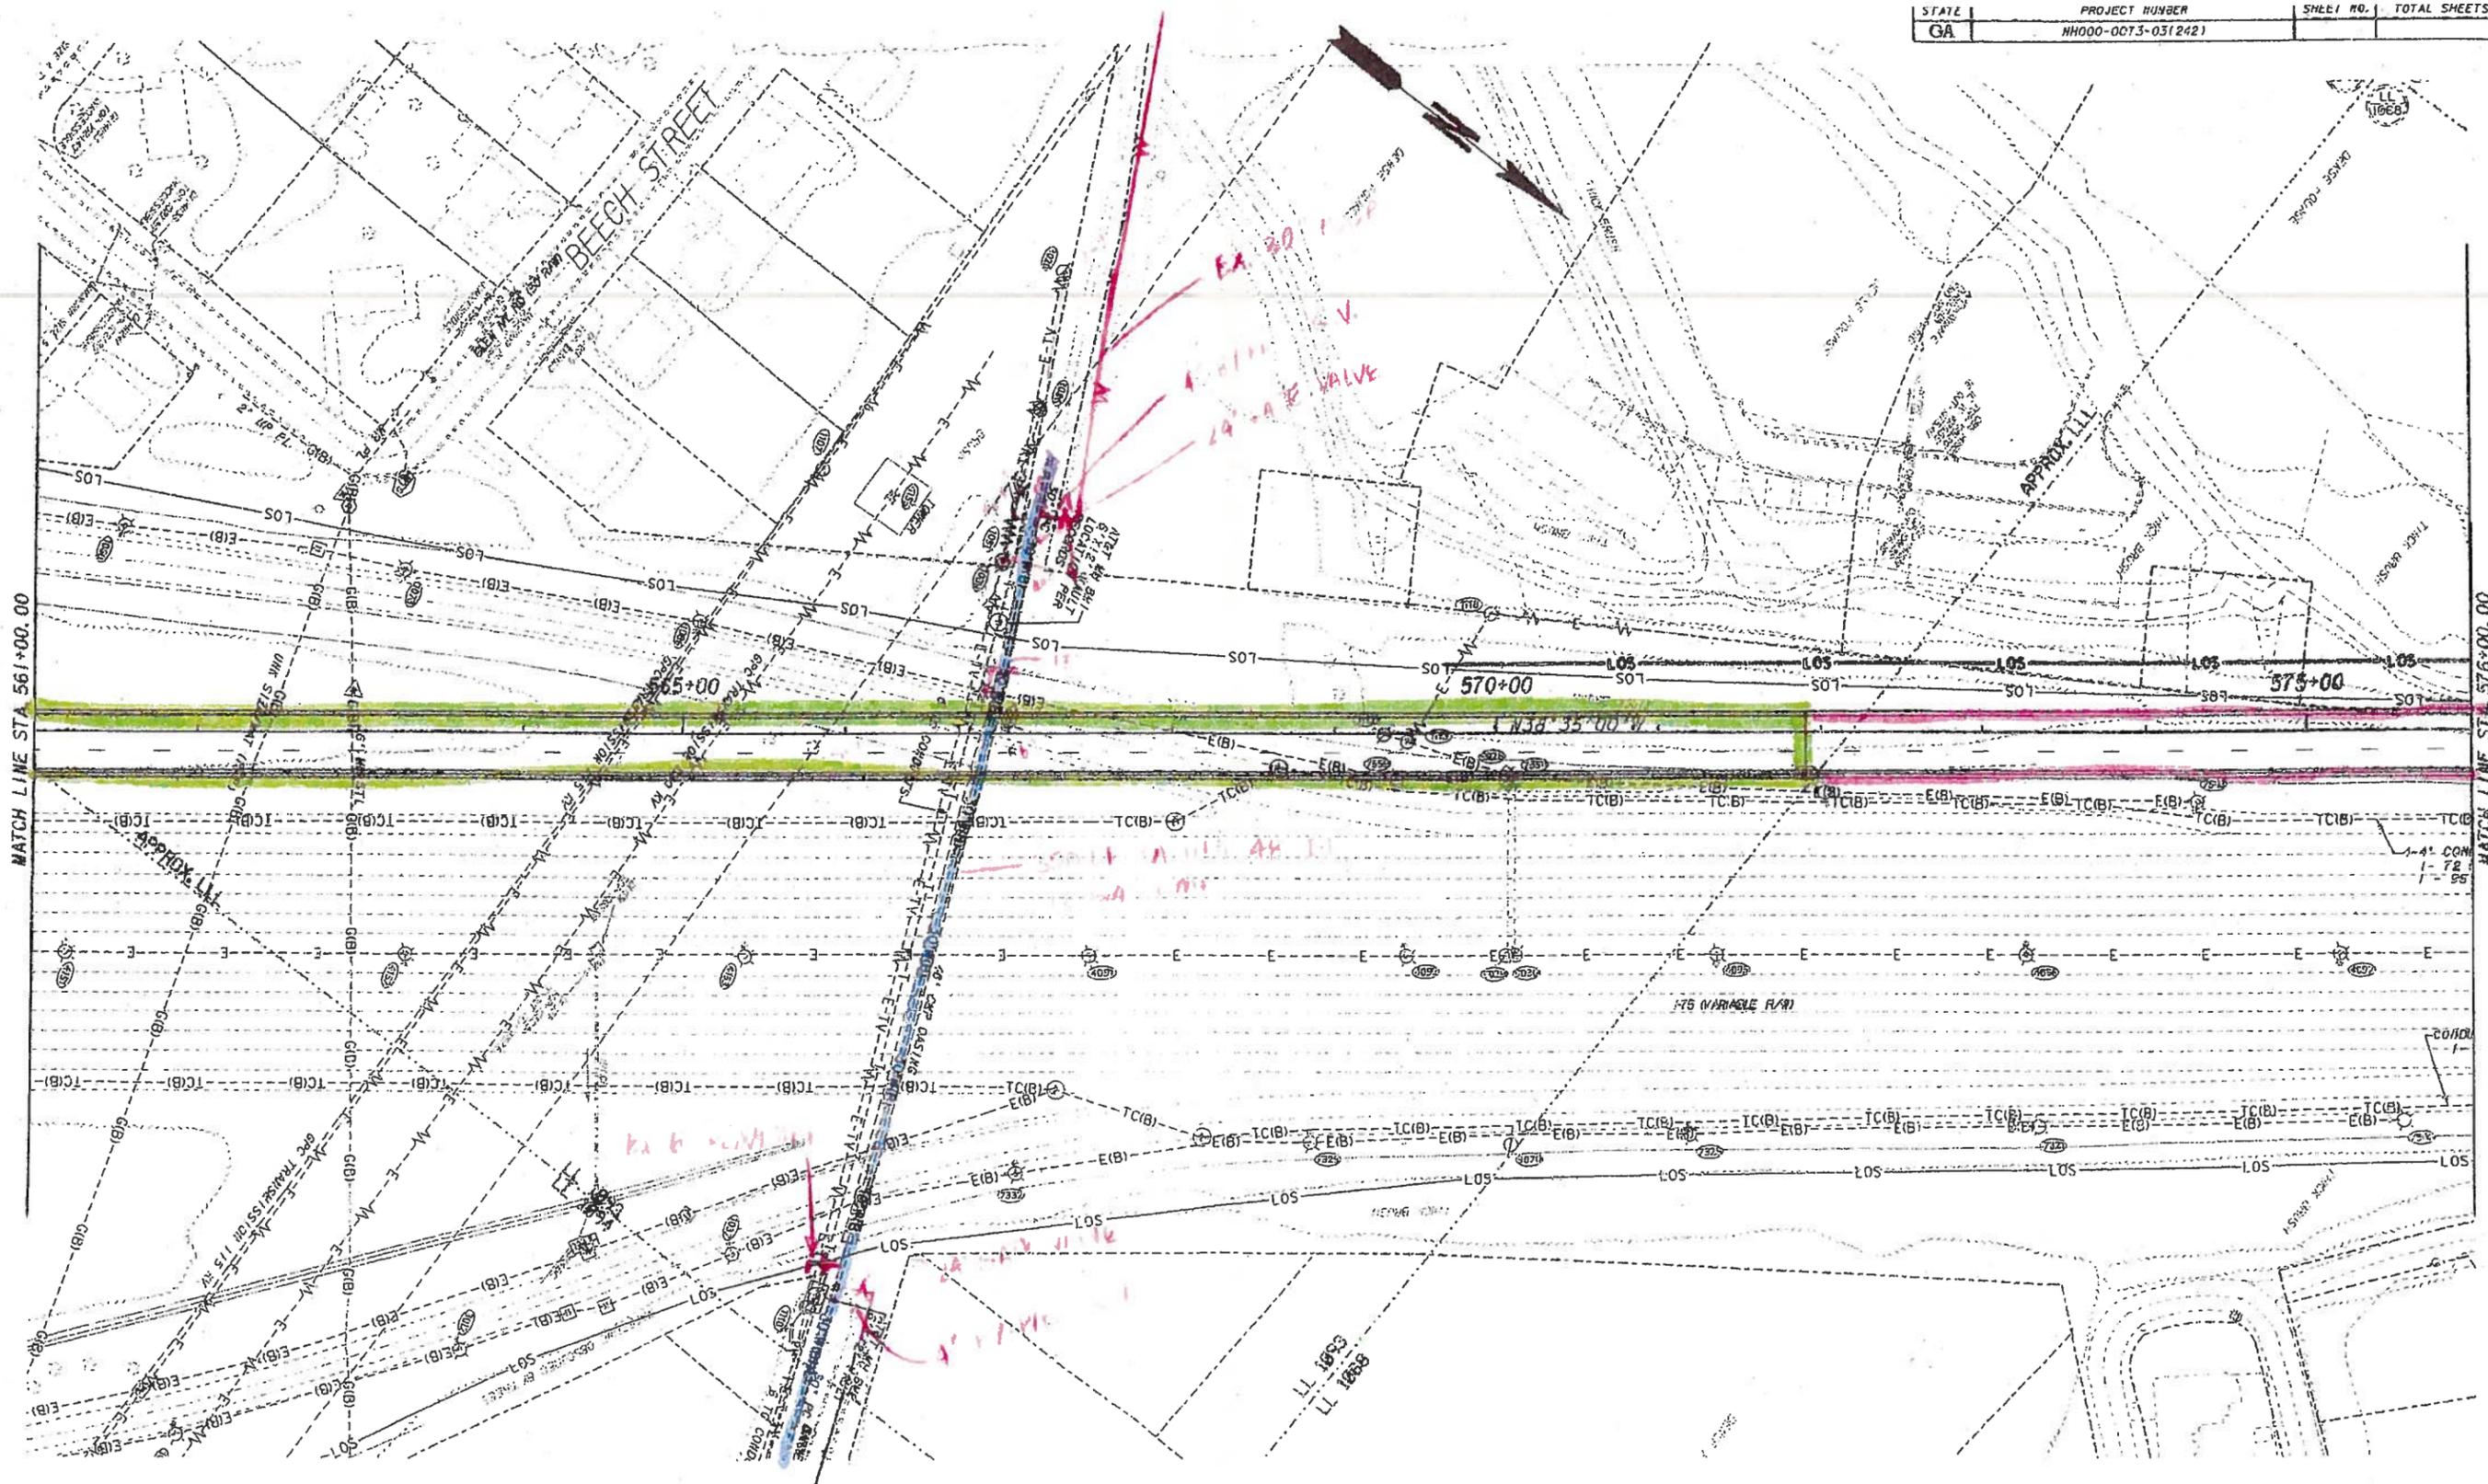

17-AUG-2009 11:05  
 8/17/2009  
 D:\175\dgn\171308P27.dgn

		TRACKING				
NO	DATE	DESCRIPTION	ORIG	CHKR	SUPV	APPR
	8/17/09	FIRST UTILITY SUSPENSION	CCC	FCY	LRM	RWJ
CLARA CASH	DATE					
DRAWN BY						
PATRICIA TSE	DATE					
CHECKED BY						
MIKE MOSELEY	DATE					
SUPERVISOR						
RON MORRIS	DATE					
APPROVED						

**GTP** GEORGIA TRANSPORTATION PARTNERS

SCALE IN FEET



DEPARTMENT OF TRANSPORTATION  
STATE OF GEORGIA

**PBS&J**


I-75 / I-575 NORTHWEST CORRIDOR

**CONSTRUCTION PLAN**

I-75 REVERSIBLE

DRAWING NO. 13-27

LL 1093, 1094  
DIST 16th

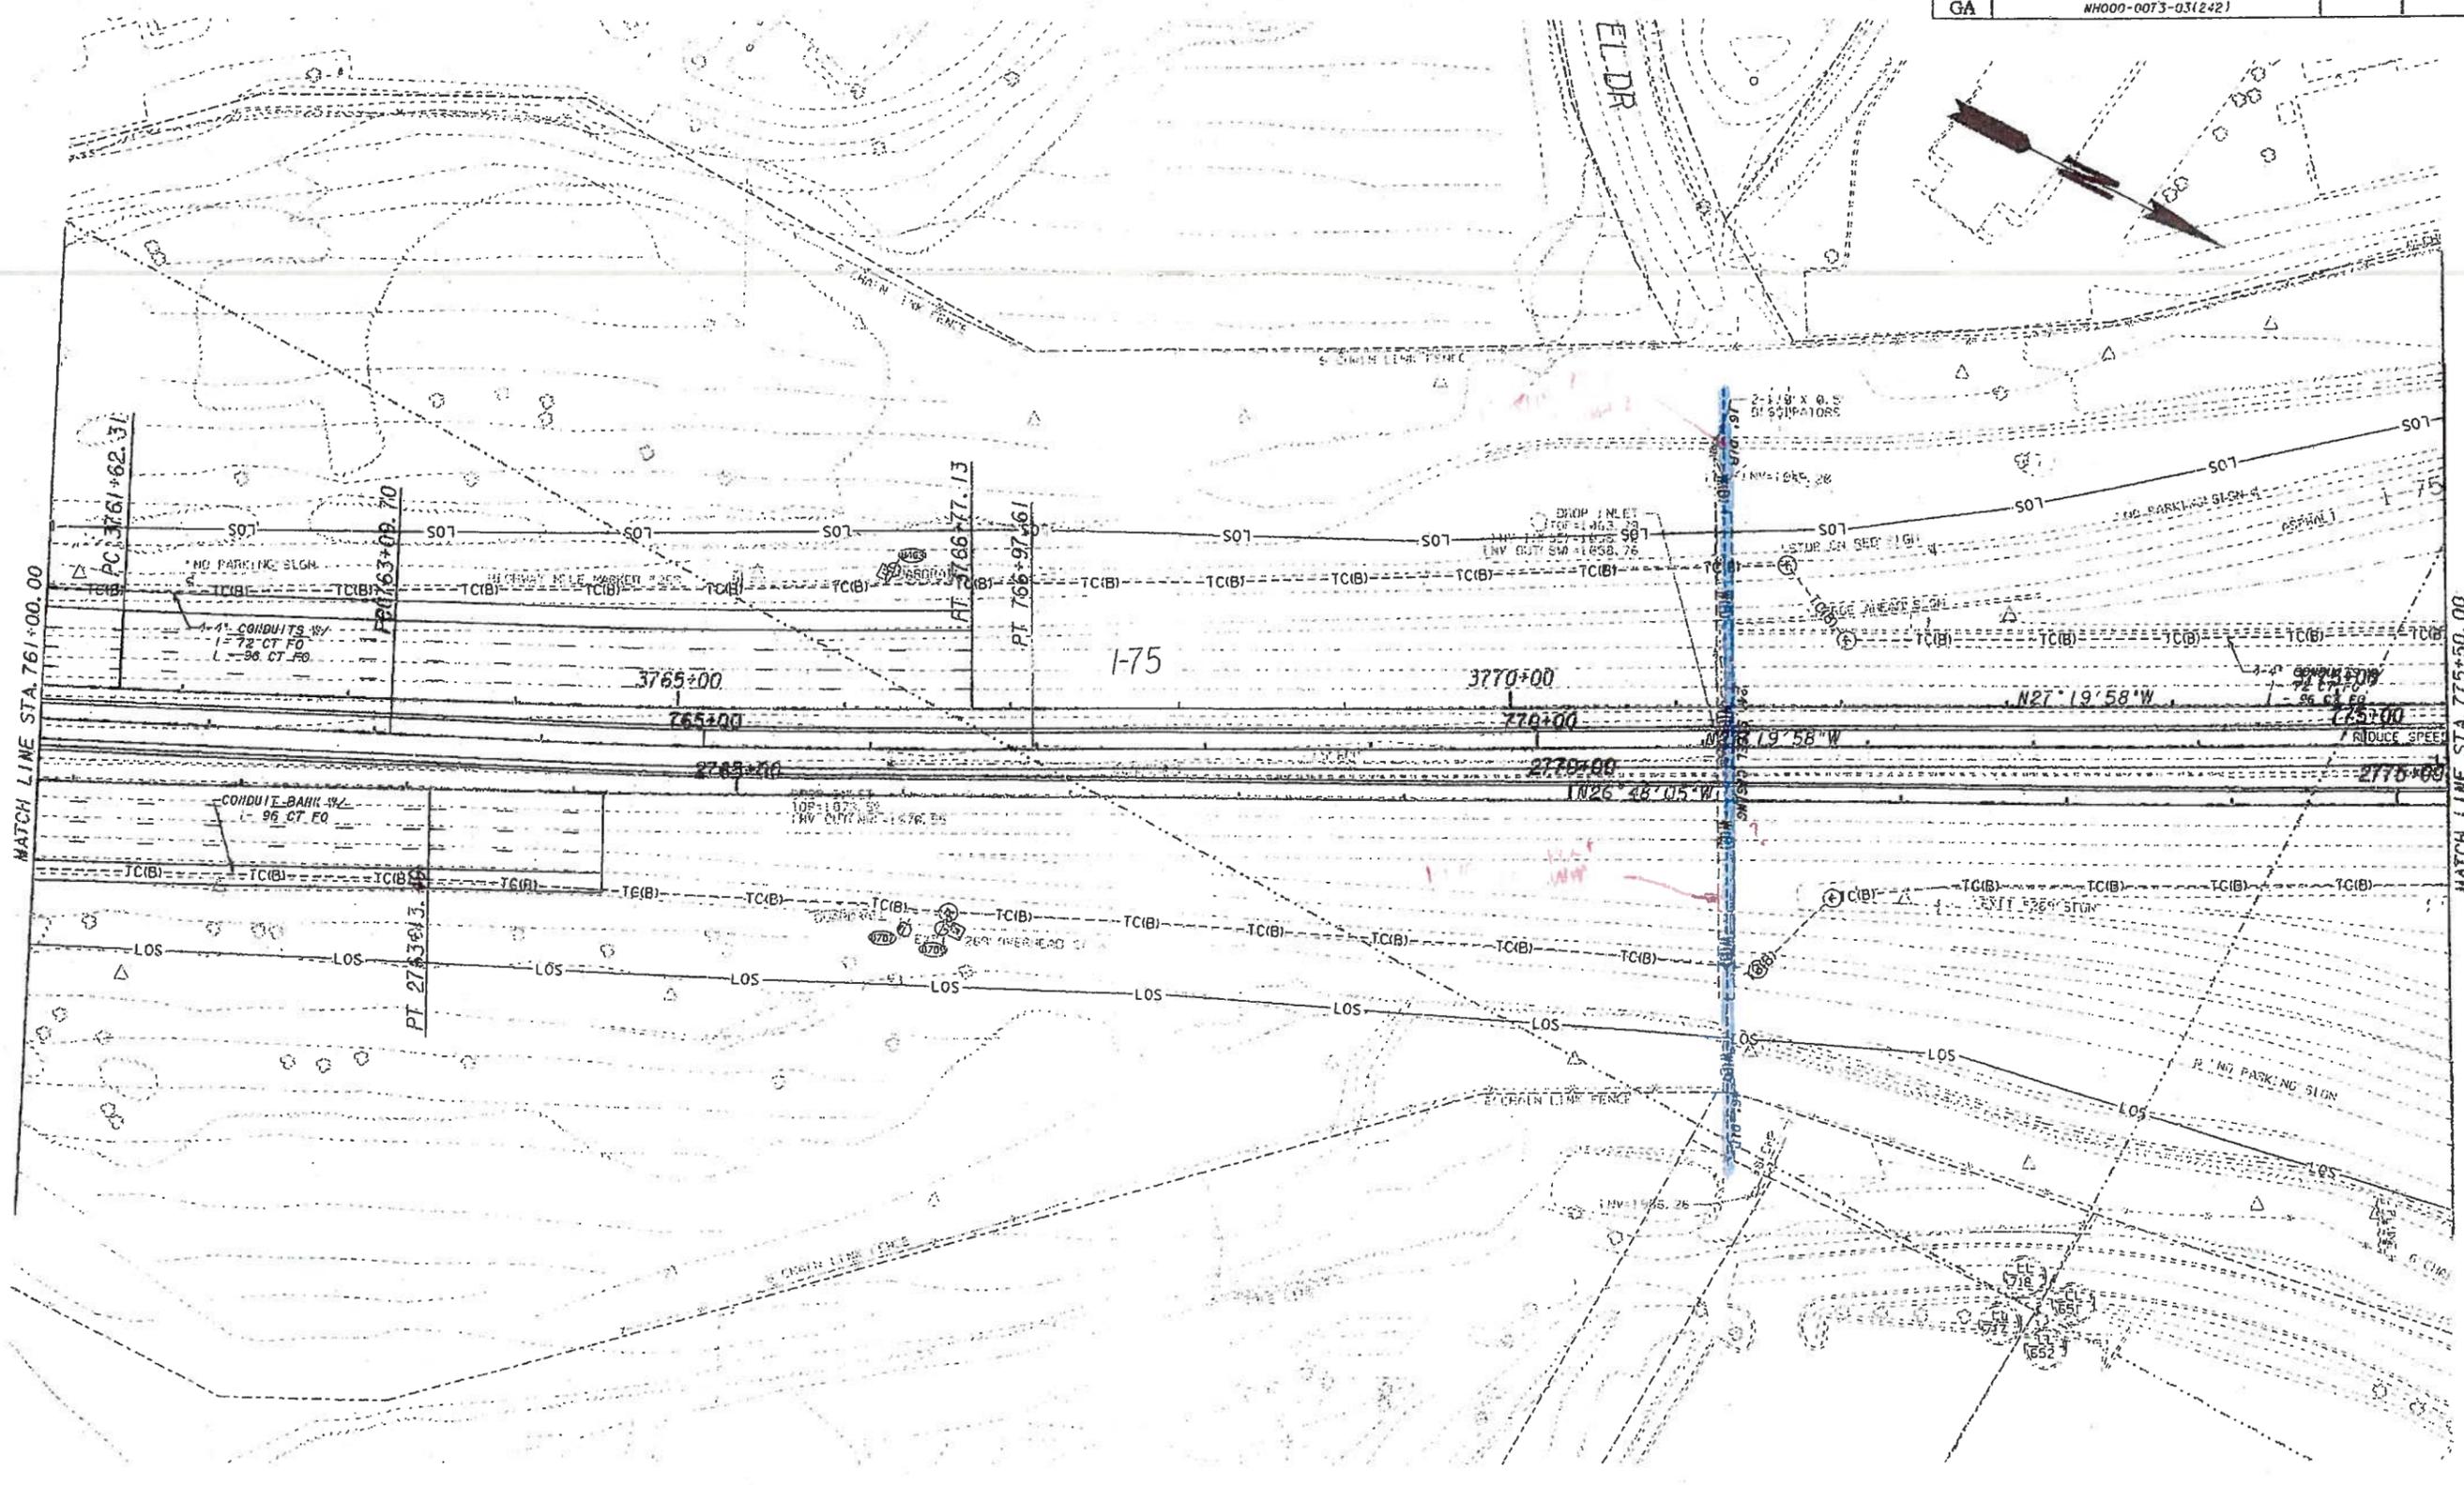

17-AUG-2009 11:55  
 S:\17\2009  
 0:\175\pdp\171209\171209-11.dgn

		TRACKING				
NO	DATE	DESCRIPTION	DRG	CHKR	SUPV	APPR
CC	PCT	MRL	KRM			
	0/17/09	FIRST UTILITY SUBMISSION				

**GTP** GEORGIA TRANSPORTATION PARTNERS

SCALE IN FEET




DEPARTMENT OF TRANSPORTATION  
STATE OF GEORGIA

**PBSJ**

I-75 / I-575 NORTHWEST CORRIDOR  
**CONSTRUCTION PLAN**  
I-75 REVERSIBLE

DRAWING No. **13-41**

LL 718, 717  
Dist 16

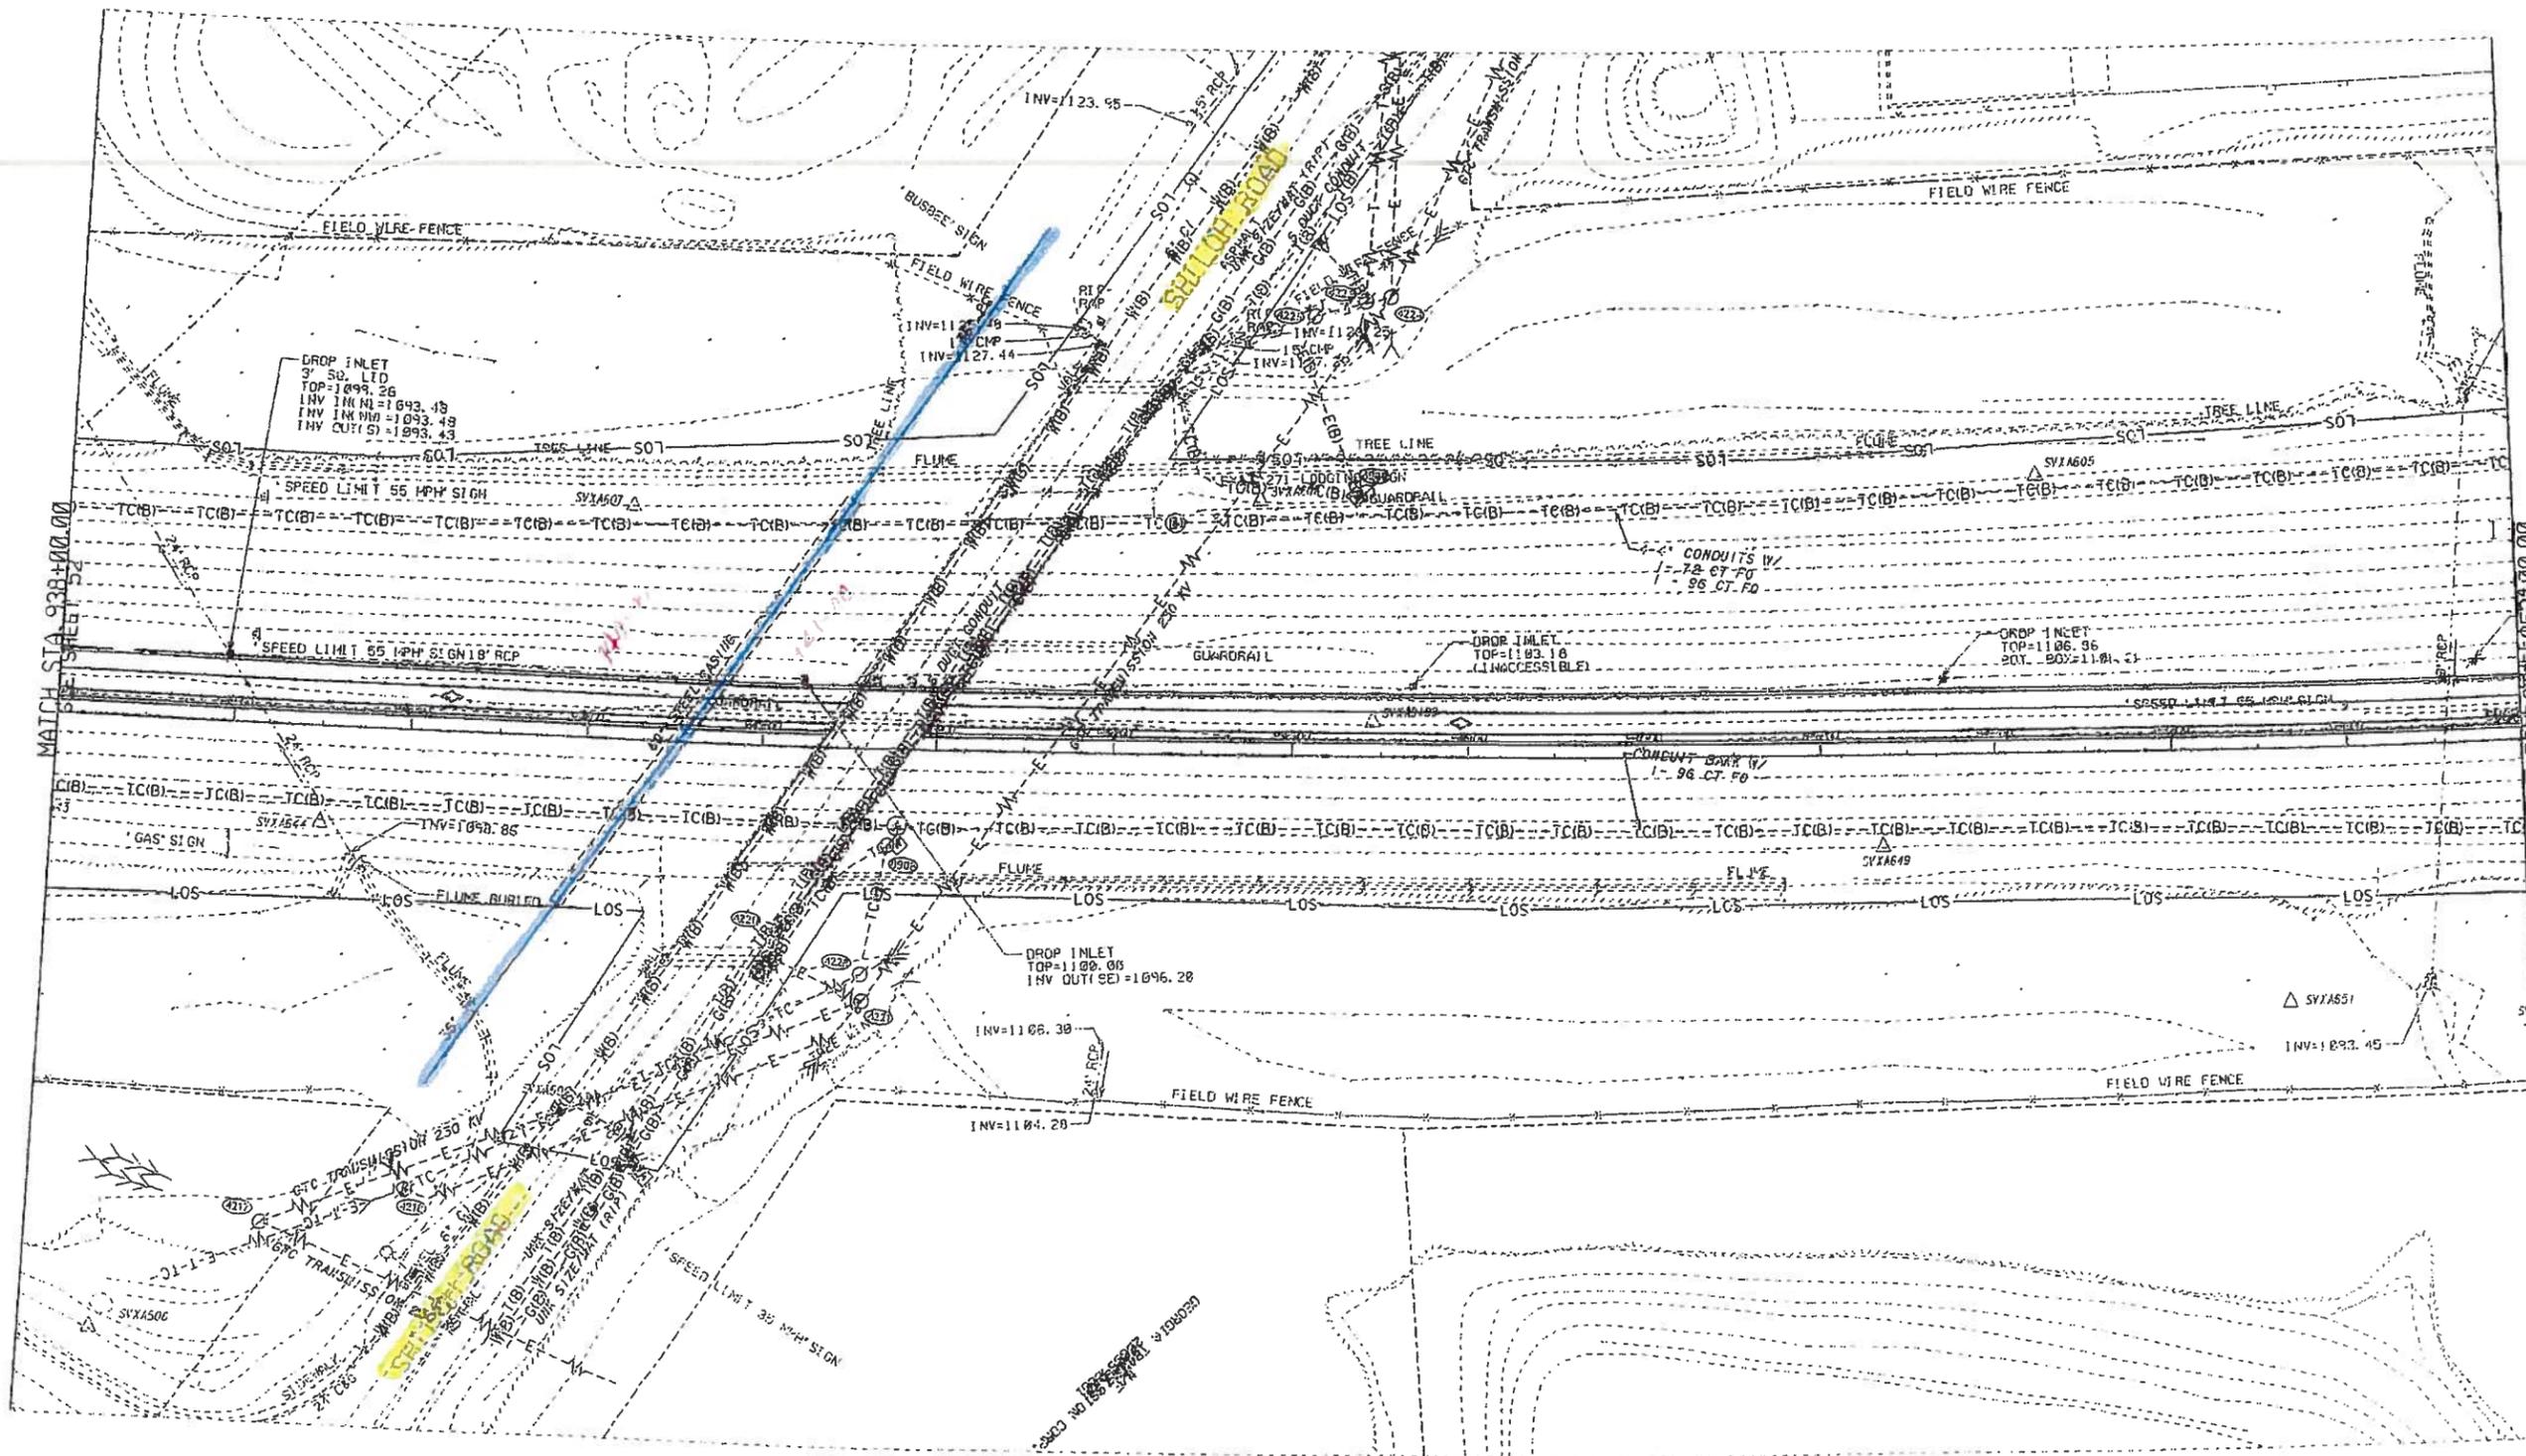

WBY FLIDERS  
 DRAWN BY  
 DATE  
 STEVE LARLEY  
 CHECKED BY  
 DATE  
 STEVE LARLEY  
 SUPERVISOR  
 DATE  
 LARRY COOK  
 APPROVED  
 DATE

TRACKING						
NO	DATE	DESCRIPTION	ORIG	CHKR	SUPV	APPR
	0-7-09	FIRST UTILITY SUBMISSION	UHS	S.A.	S.J.L.	LFC


**GTP** Georgia Transportation Partners  


SCALE IN FEET  
 0 50 100 200

DEPARTMENT OF TRANSPORTATION  
 STATE OF GEORGIA  

**J.B. TRIMBLE, INC.**  
 2650 Heritage Court SE  
 Suite 230  
 Atlanta, Georgia 30329

1-75 / 1-575 NORTHWEST CORRIDOR  
**CONSTRUCTION PLAN**  
 1-75 REVERSIBLE  
 DRAWING NO. 13-53

LL 59  
 11-24-09